

1647548

SR 1651

Septic Tank	1000	Gals.
Disp. Field	290'	L.F.T
Other		
☒ New		
☐ Repair		

NORTHEAST TRI-COUNTY HEALTH DISTRICT
Division of Environmental Health
☒ Colville Office, Box 270, Phone 684-2262
☐ Newport Office, Box 490, Phone 447-3131
☐ Republic Office, Box 584, Phone 775-3161

Permit No. c 7876

Fee Paid \$150.00

Receipt No. 942 638

William Wilden is hereby authorized to utilize a sewage disposal system at Portion of Tax #11
Sec 34 Twp 33 Rng 37 and in accordance with the plans and specifications approved by the District Health Officer on file in this office.

Any major repairs or alterations to the system shall be reported to the Northeast Tri-County Health District (Division of Environmental Health) for approval PRIOR to construction.


This permit is issued and may be revoked by the Northeast Tri-County Health District Health Officer by the authority of WAC 246-272, and Rules and Regulations established by the Board pursuant to RCW 72.05.

Witness my hand and seal this 1st day of July, 1993

Date of Inspection 10/22/92 E. Moore

[Signature]
District Health Officer

67876
34-33-37

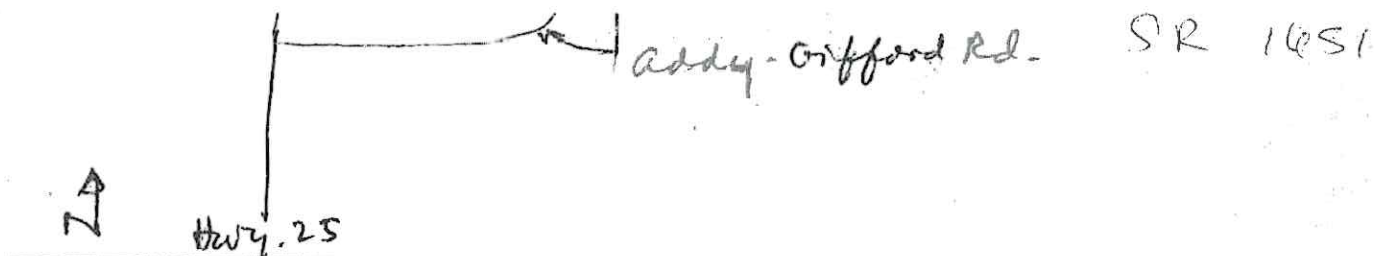


FOR OFFICE USE ONLY BELOW THIS LINE

cover feathered 10-15' beyond trench perimeters; three (3) 74' lines must be served by d-box. Otherwise, most preferable area for original & replacement areas is in field approximately 500' W. of house site. ~~Will~~ Will contact applicant to discuss. MHA

5/11/93 - Larry came in to office. Plans approved for DF in field 500' below house site. Gave him list of certified installers. MHA


9/14/93 - Larry came in to office. He will be doing work himself. Went over spec. details w/ him. MHA

Ad Built
10/22/93 EAM

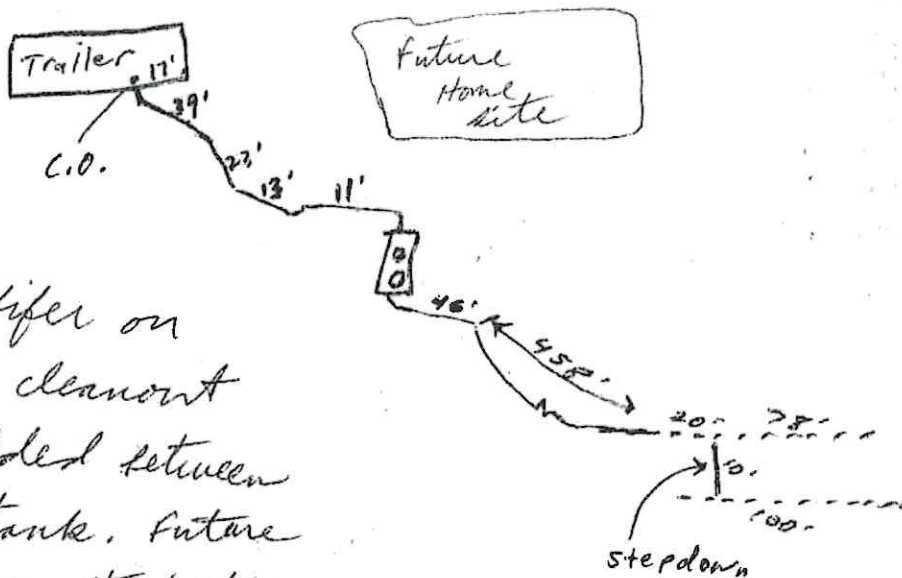

Told Larry fifer on site that a cleanout should be added between trailer and tank. Future home will have straight shot into tank.

Lany - Fife 6/11/93

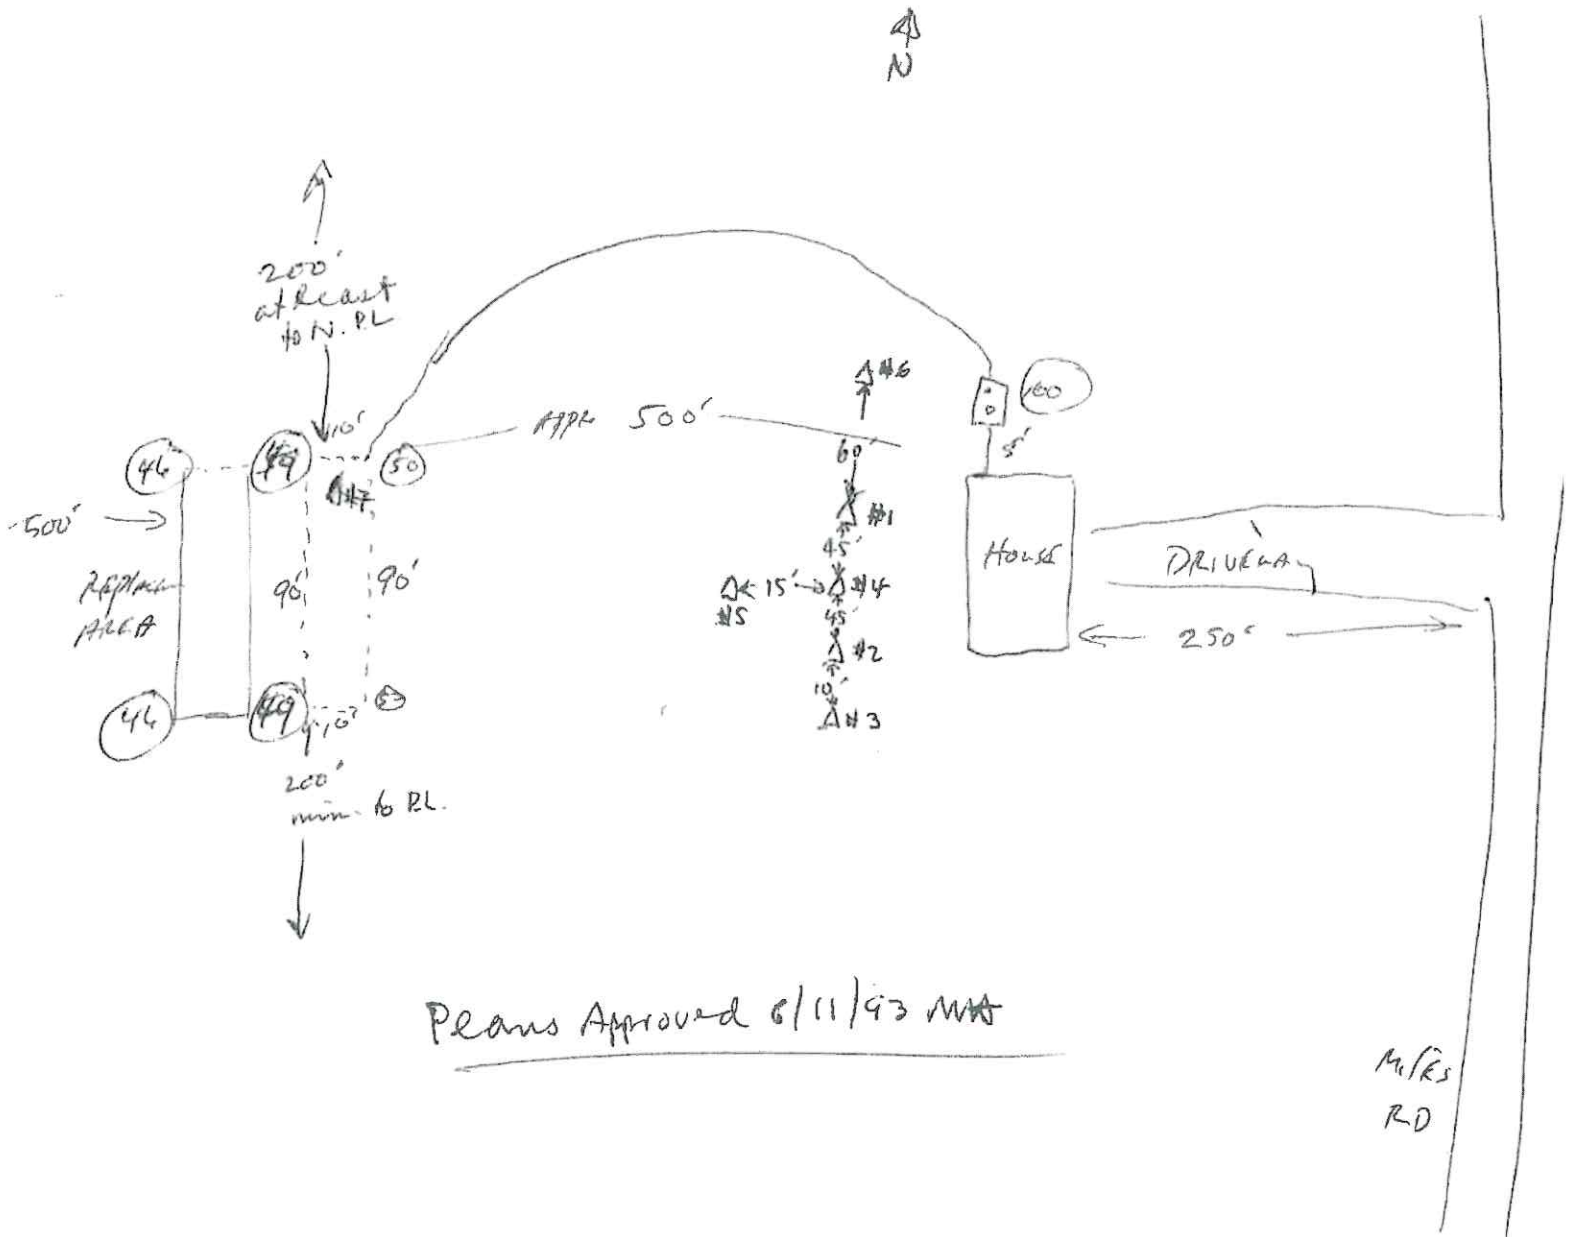

**NORTHEAST TRI-COUNTY HEALTH DISTRICT
SEWAGE DISPOSAL SYSTEM PERMIT APPLICATION**

Property Owner Name LARRY W. E. FOR

Mailing Address STAR RT A

City, State INCHWILL WA Zip 99138 Phone 733 4848

Legal Description Sub 1 of Section 11
(lot, block, subdivision or rural description) (parcel number)

Sec. 34 Twp. 33N Rge. 37E Acreage or Lot Size 20 ACRES

A permit can not be issued until the legal description can be verified. To verify legal descriptions, a copy of the most recent property tax statement or legal description from the County Assessor's office must be submitted.

Type of System: ☒ new ☐ repair/replacement Water Supply: ☒ public/community ☐ private(one connection)

Type of Structure: ☒ residential ☐ commercial Design Criteria: # bedrooms 3
other

Septic Tank: Capacity 1000 Gal. Drainfield: Total Linear Feet 200
Material concrete Trench Depth 21 1/2 Ft.
Trench Width 3 Ft.

PLOT PLAN

For Office Use Only		North	
Depth	Soil Type		
6/10/93	MB		
#1 0-24	gravelly silt loam		
24-72	" cobbly sandy loam		
#2 0-32	" silt loam (bedrock @ 32?)		
#3 0-48	" " "		
48-72	sandy clay or clay loam	#7 0-18 loam	
#4 0-18	gray silt loam	18-72 fine sandy loam	
18-48	" cobbly sandy loam		
#5 0-12	gray silt loam		
12-48	" cobbly sandy loam		
#6 0-18	silt loam		
18-32	cobbly sandy loam - bedrock @ 32		

PLEASE PROVIDE DETAILED DIRECTIONS TO PROPERTY ON THE REVERSE SIDE FORM
If you hire someone to install all or part of this system, including any excavation work, they must have a current sewage installer certificate issued by Northeast Tri-County Health District.

I CERTIFY THAT THE INFORMATION ON THIS APPLICATION IS CORRECT:

Applicant Signature Larry W. E. For Date 6-28-93 Phone 733 4848

Name of Certified Installer Not Determined License # Not Determined


FOR OFFICE USE ONLY

Date Received 6-8-93 Fee \$ 150⁰⁰ Rec. # 942638

NETCHD Approval:	Planning Dept.:
Legal <u>OK 6/30/93 M</u>	Floodplain <u>none</u>
Soil Log <u>6/10/93 M</u>	Shoreline <u>none</u> 7/1/93
Plot Plan <u>6/11/93 M</u>	Planning Dist. <u>OK</u>
Permit issued	Platting
Final insp <u>10/22/93 in more</u>	SEPA

Comments: 6/10/93 - Extensive rock outcroppings & shallow bedrock in applicant's originally-proposed d.f. area. Can do 12" max. depth trenches in that area (between test holes 1 & 2) w/ 1 1/2 - 2' native soil.


DIRECTIONS:

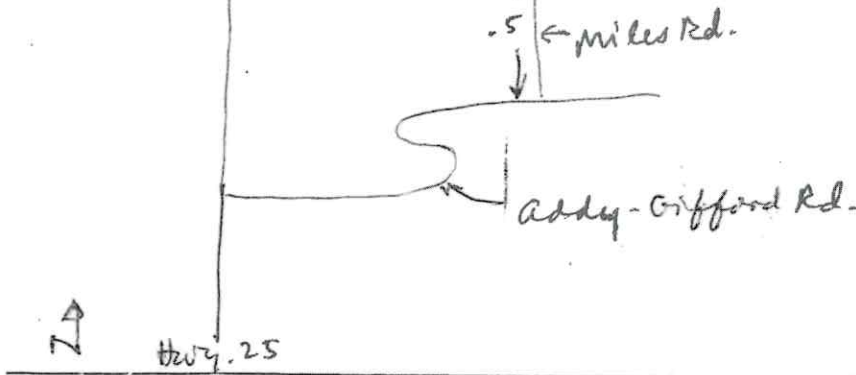

FOR OFFICE USE ONLY BELOW THIS LINE

cover feathered 10-15' beyond trench perimeters; three (3) 74' lines must be served by d-box. Otherwise, most preferable area for original & replacement areas is in the field approximately 500' W. of house side. ~~Will~~ Will contact applicant to discuss. MWT
 6/11/93 - Larry came in to office. Plans approved for DF in field 500' below house side. Gave him list of certified installers. MWT
 9/14/93 - Larry came in to office. He will be doing work himself. Went over spec. details w/him. MWT

As Built
 10/22/93 EAM

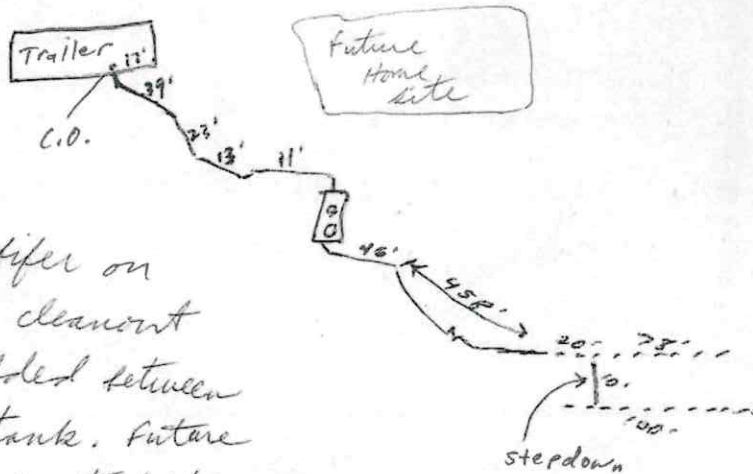

Told Larry fifer on site that a cleanout should be added between trailer and tank. Future home will have straight shot into tank.

8/8/17

Think this is it - DF is 500' from house

Fifer SP
 Lot #2

[illegible]

2 MILE N. ON Miles RD

~~532.71~~
529.83
~~531~~
530


.975 TS

.980
517.17

$$= \frac{1}{x}$$

~~1" = 527.72 ft~~

1" = 530 ft

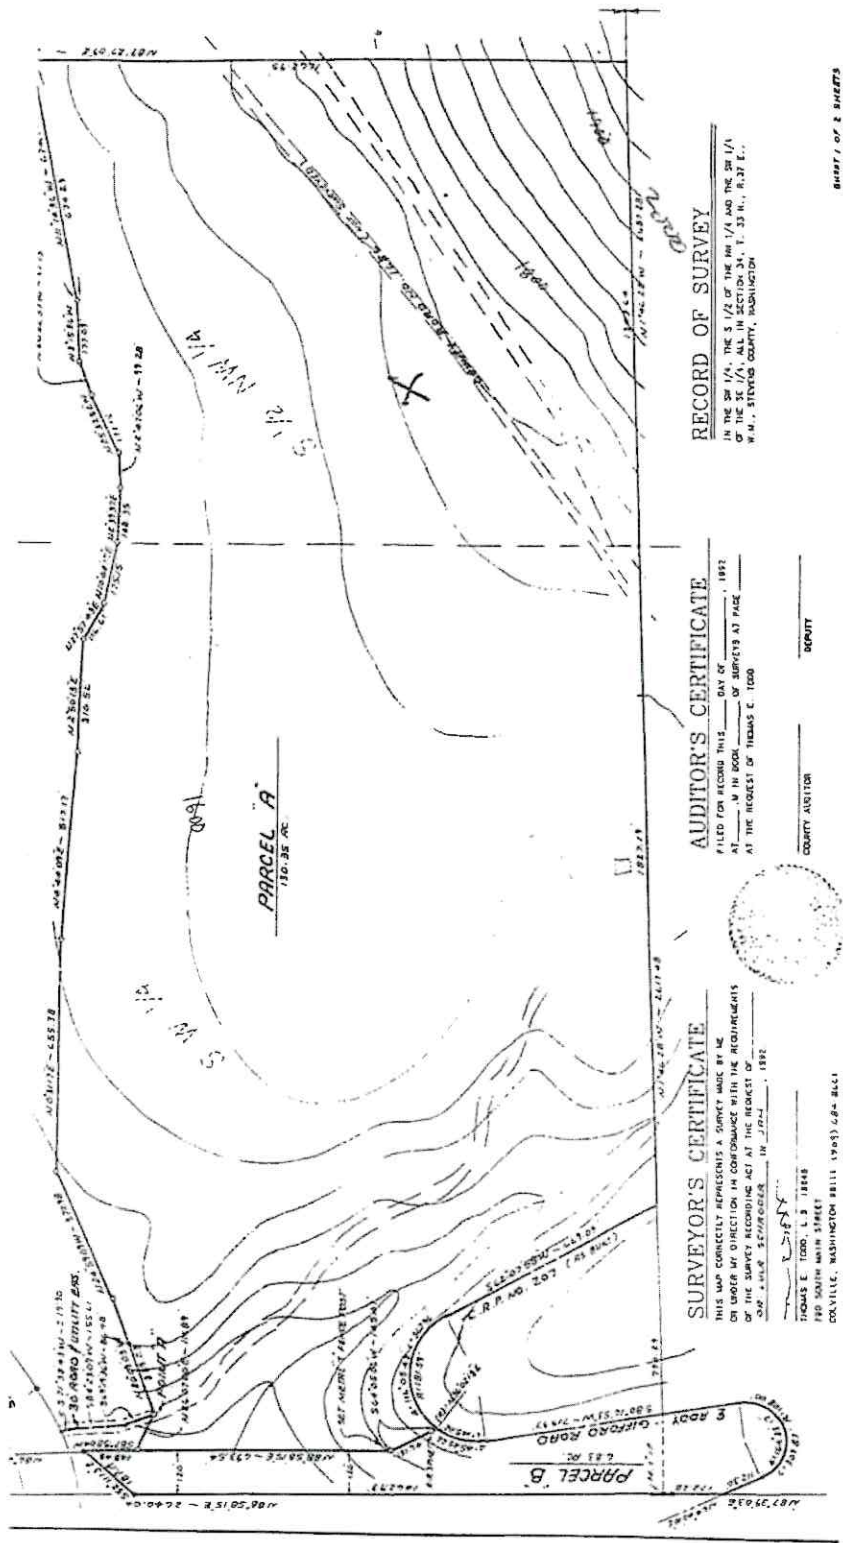

Lamy - Faye 6/11/93

