


As-Built by  
Paul Greenwalt

10/18/95

SL6746

Air strip

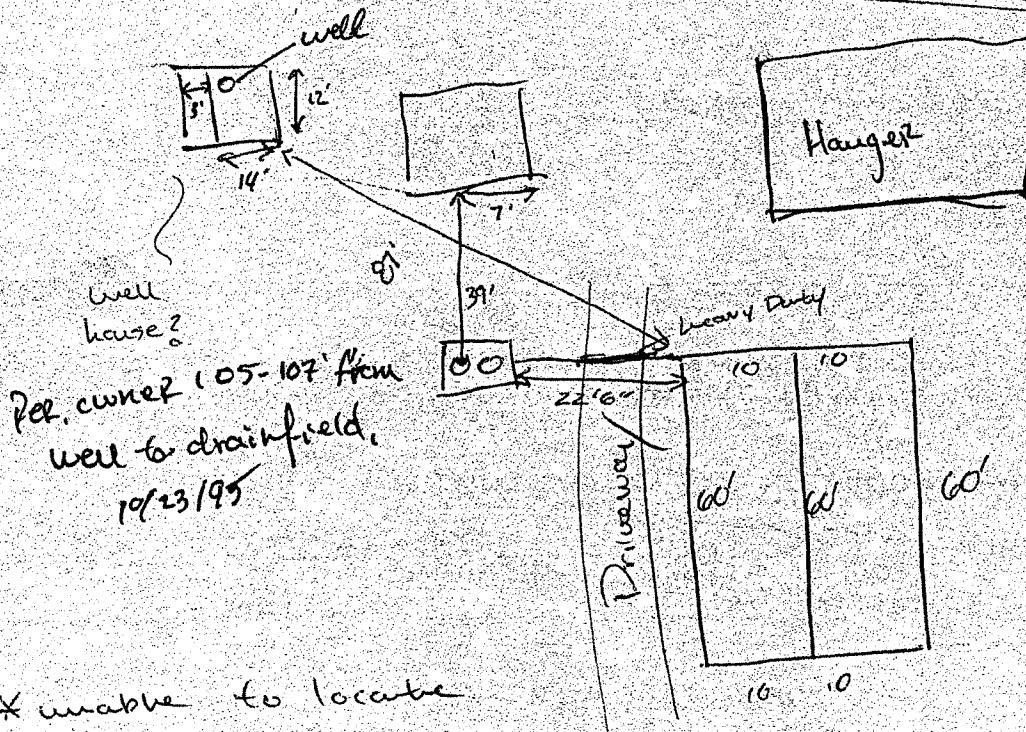

\* unable to locate well - PDG

10/18/95 - spoke w/ installer to determine well location. Randy Long said the owner told him the well was 110' from Drainfield. Left message w/ Randy Long to have home owner call our office and discuss. ~~Page~~ Bob House called and discussed well location w/ me. He said the well is located in the far N.E. corner of the well house and is approx 105-107' away from the Drainfield. For discussion w/ Charles Knight to approve based on Bob House's information. PDG

SR 6746

Septic Tank	1000	Gals.
Disp. Field	200	L.F.T
Other		
<input checked="" type="checkbox"/> New		
<input type="checkbox"/> Repair		

*renewal*  
*10-19-94*  
*rec# 7677*  
*-220' of drain field*  
*Installed*

**NORTHEAST TRI-COUNTY HEALTH DISTRICT**  
 Division of Environmental Health

- Colville Office, Box 270, Phone 684-2262
- Newport Office, Box 490, Phone 447-3131
- Republic Office, Box 584, Phone 775-3161

Permit No. 8366

Fee Paid \$150.00

Receipt No. 751761

Robert House is hereby authorized to utilize a sewage disposal

system at Tax #3, UND 1/5 INT TAX #5, Sec 11 Twp 29 Rng 40 and in accordance with the plans and specifications approved by the District Health Officer on file in this office.

Any major repairs or alterations to the system shall be reported to the Northeast Tri-County Health District (Division of Environmental Health) for approval PRIOR to construction.

This permit is issued and may be revoked by the Northeast Tri-County Health District Health Officer by the authority of WAC 246-272, and Rules and Regulations established by the Board pursuant to RCW 70.05.

Witness my hand and seal this 27th day of October, 1993

Date of Inspection 10/23/95  
 District Health Officer [Signature]

8366  
 11-29-40