

**NORTHEAST TRI COUNTY HEALTH DISTRICT
DIVISION OF ENVIRONMENTAL HEALTH**

ON-SITE SEWAGE SYSTEM PERMIT # PT0020188

Eric & Kaye Skirko is hereby authorized to utilize a sewage disposal system at
TAX #17 (SP 75-93-4)

Section: 24 Township: 36 Range: 39 Parcel #: 2297961

in accordance with the plans and specifications approved by the District Health Officer on file in this office.

Prior to any major repairs, replacements or alterations to the system a permit shall be obtained from the Northeast Tri County Health District (Division of Environmental Health).

This permit is issued and may be revoked by the Northeast Tri County Health District Health Officer by authority of WAC 246-272, and Northeast Tri County Health District Regulations established by the Board of Health pursuant to RCW 70.05.

Additional permits from other jurisdictions or agencies may be necessary for this project. It is the responsibility of the applicant to acquire said permit(s), and comply with all applicable rules, regulations and/or ordinances.



Date Issued: 08/09/2022

District Health Officer

PERMIT INSTRUCTIONS

STRUCTURE TYPE: Single-Family Residential

NUMBER OF BEDROOMS: 4

DESIGN FLOW (gal/day): 480

TYPE OF SYSTEM: New

SYSTEM DESIGN: Pressure w/ Gravelless Chambers

SEPTIC TANK CAPACITY(gal): 1500

DFLF/BED DIMENSIONS: 344

TRENCH DEPTH (inches): 15

TRENCH WIDTH (inches): 36

APPURTENANCES: Effluent Filter

PUMP CHAMBER (y/n): Y

PUMP CHAMBER GALLONS: 1000

REASON FOR SYSTEM DESIGN: 15% reduction from 400' for chambers

SPECIAL PERMIT INSTRUCTIONS: System Design: Pressure Distribution w/ Chambers & Curtain Drain

FINAL INSPECTION DATE: 8/11/22


Initials: BK

Stevens County Office	240 E Dominion	Colville,	WA	99114	(509) 684-2262
Pend Oreille County Office	605 Hwy 20	Newport,	WA	99156	(509) 447-3131
Ferry County Office	P.O. Box 584	Republic,	WA	99166	(509) 775-3111



On-Site Sewage System As-Built Drawing for Permit # PT 20188

Inspection Date	8/11/22	Approved ☒ Yes ☐ No	Approved Date	8/11/22
Inspection By	BH		Re-Inspection Date	

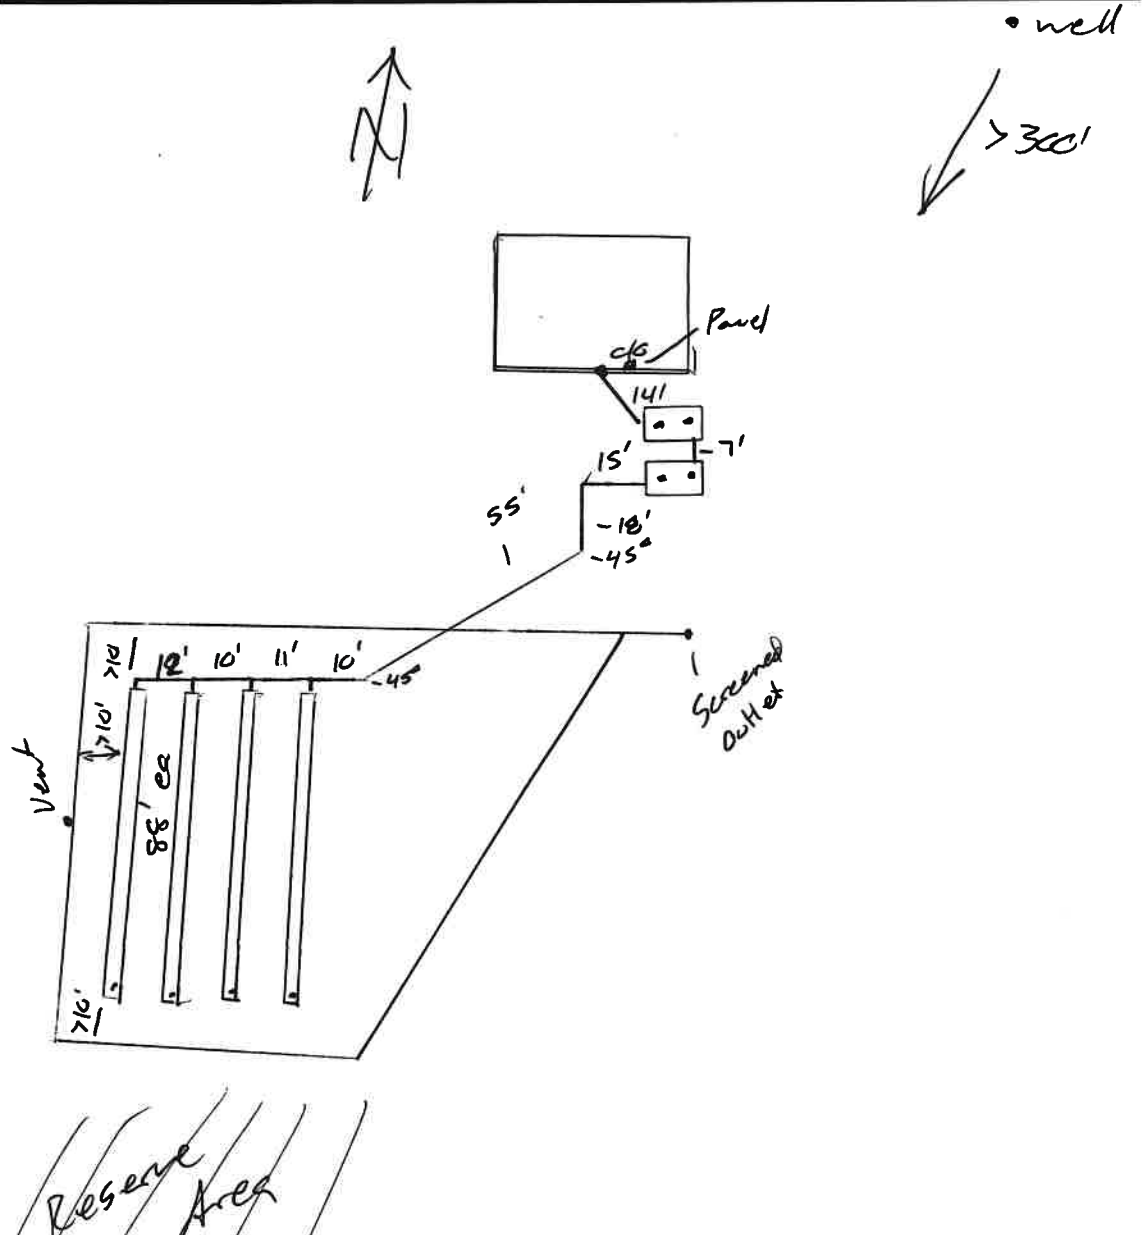

Installer Name	David Hall		Pump Chamber Size	1000
Septic Tank Size	1500	Dose/day	4	Gallons/Dose
Drainfield Length	352'	Squirt Height	>5'	Drawdown
Drainfield Depth	15"	Pump Run Time	3:00	
Septic Tank Latitude/Longitude	48.6115 / -117.8404			